


ICT-3 under
WR-ER Inter
regional network
expansion
scheme Part A

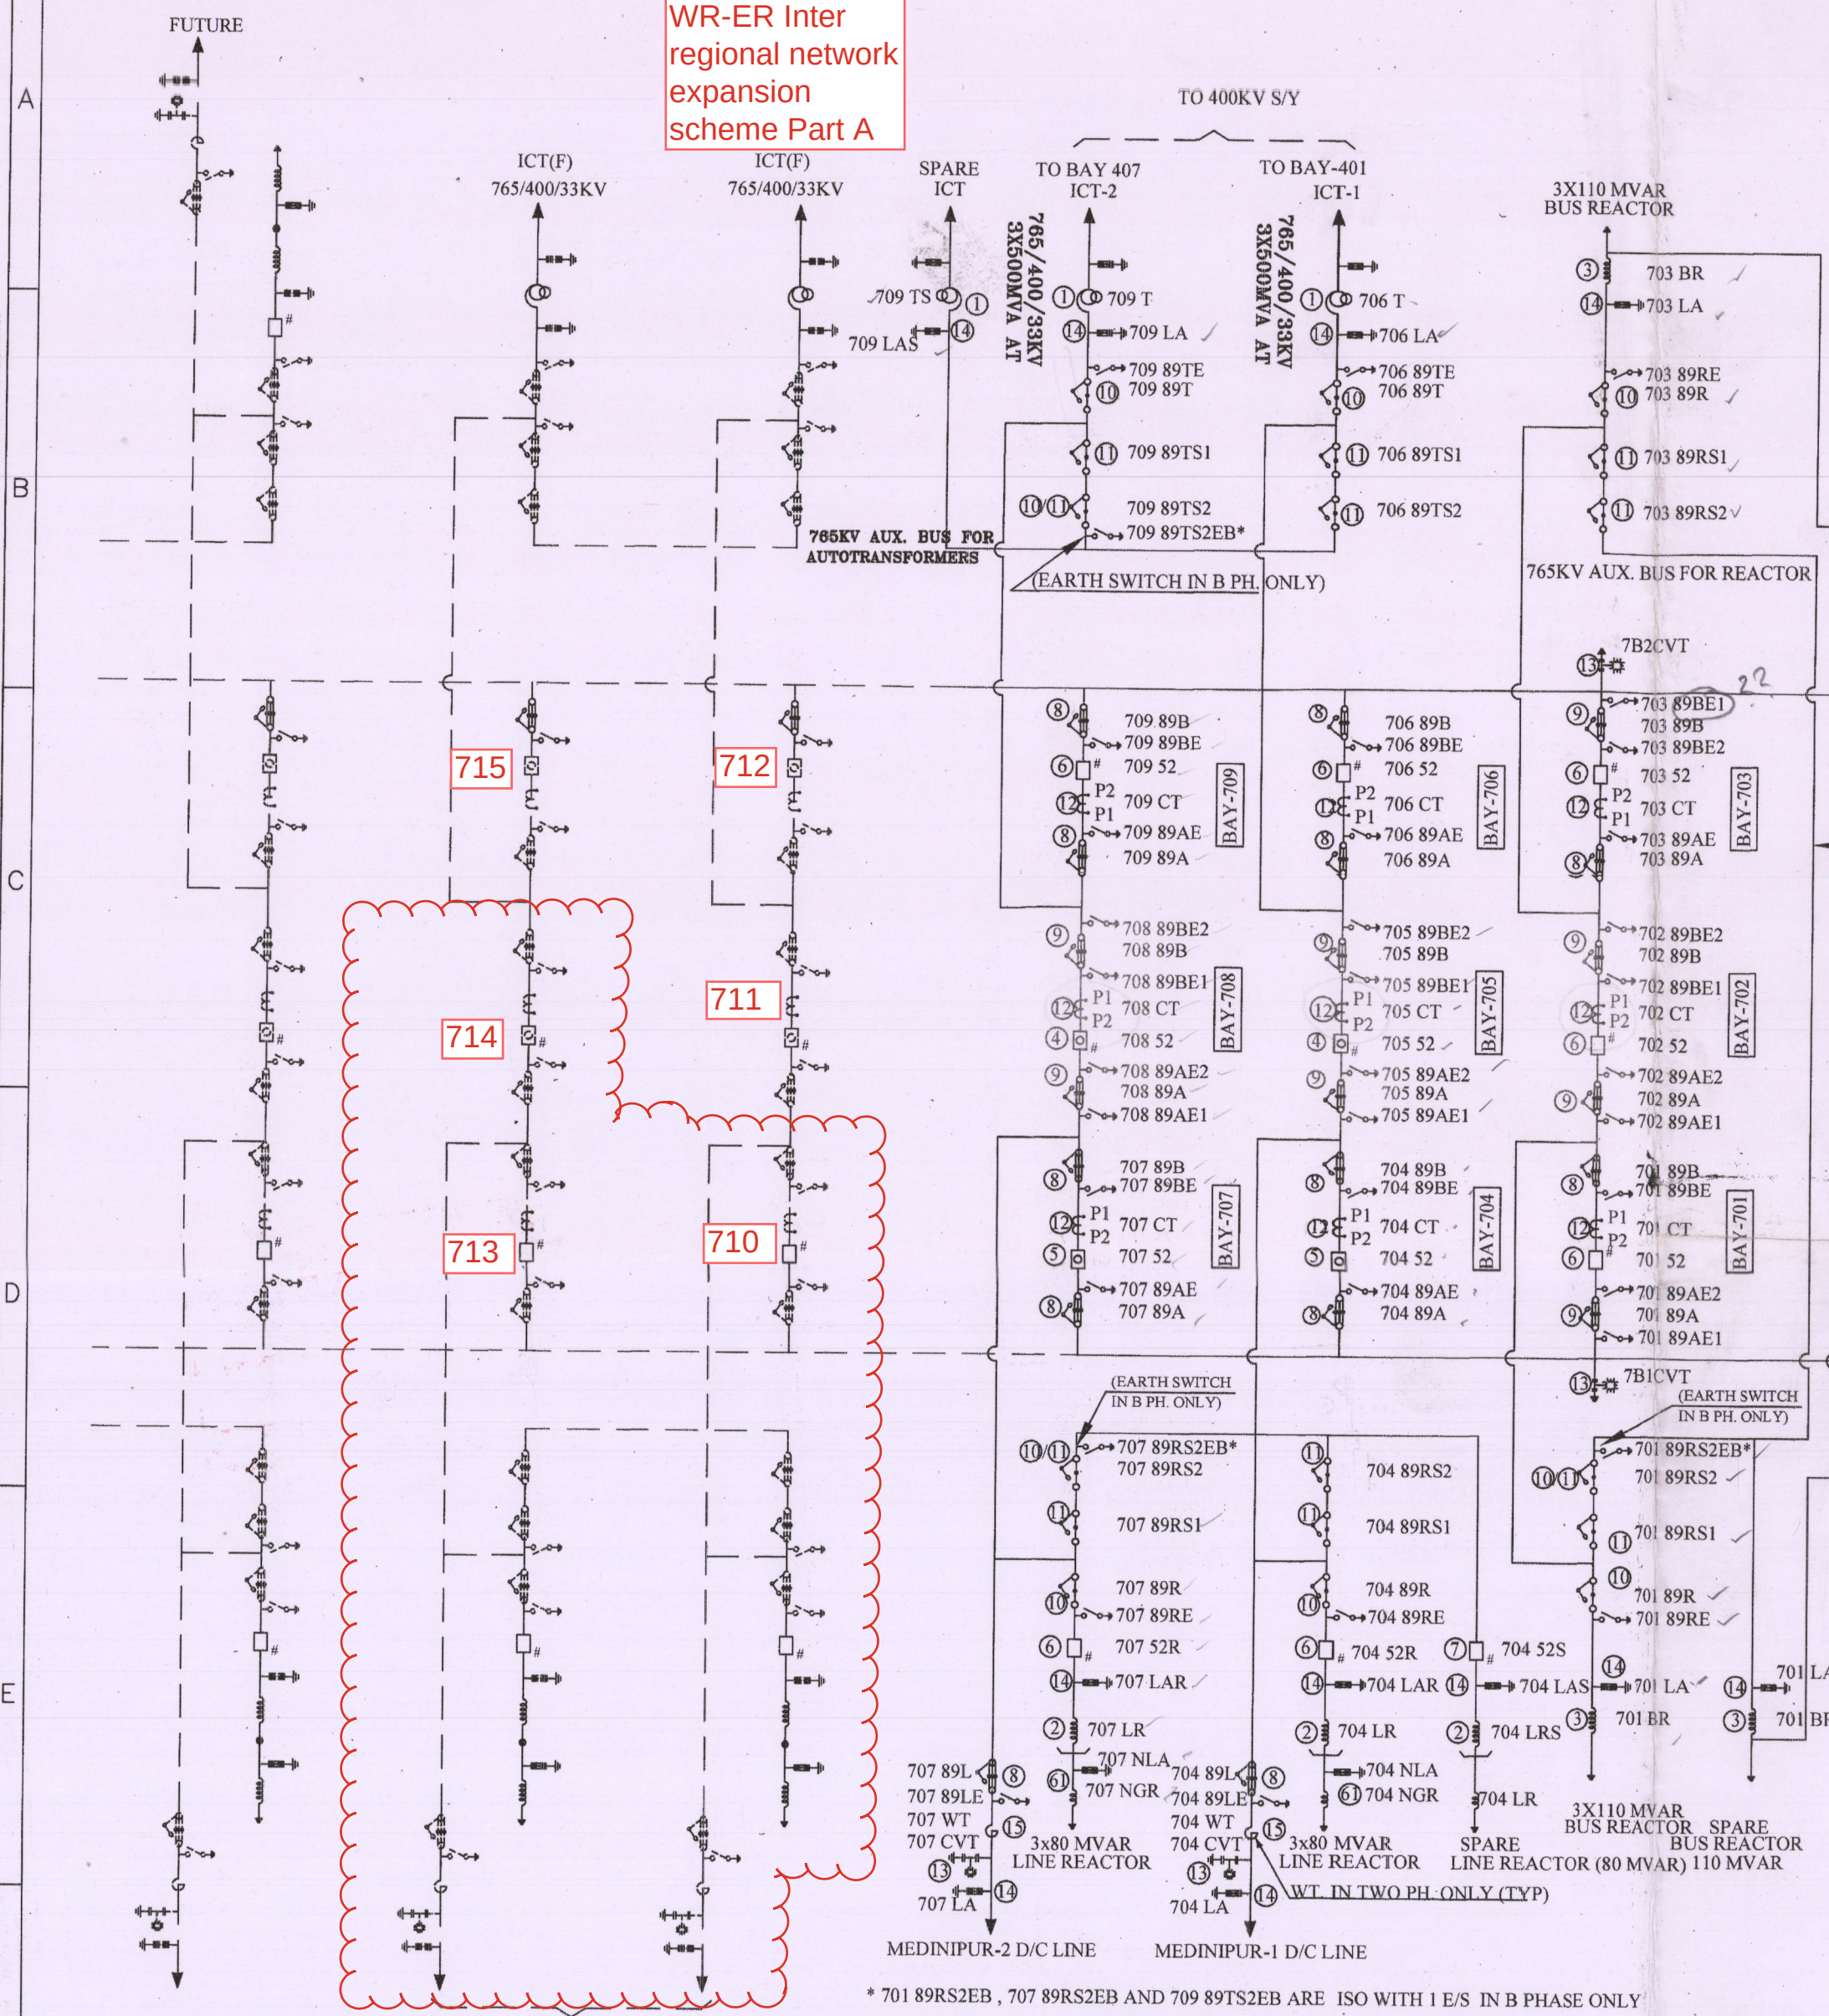

* 701 89RS2EB, 707 89RS2EB AND 709 89TS2EB ARE ISO WITH 1 E/S IN B PHASE ONLY

Durgapur D/C line
under ERES-47
scheme

REV.	DATE	ALTERED CHECKED APPROVED	REV.	DATE	ALTERED CHECKED APPROVED	REV.	DATE	ALTERED CHECKED APPROVED	REV.	DATE	ALTERED CHECKED APPROVED	PK MM/RO DMM/PPK
ZONE			ZONE			ZONE			ZONE	31.03.18		DRG REVISED AS PER PGCIL COMMENTS DATED 26.12.17


SL.NO.	DESCRIPTION	RATING	S. C. RATING	QTY. (NO.)	SYMBOL	SCOPE OF SUPPLY	LEGEND	MAKE
1	500 MVA, (1-PH) AUTOTRANSFORMER, YNa0d11	765/400/33KV	50 KA FOR 1 S.	7 ✓		PMJTL	T	TBEA
2	80MVAR LINE REACTOR (1-PH) WITH NGR(600 Ohm).	765KV	50 KA FOR 1 S.	7 ✓		PMJTL	LR/NGR	TBEA
3	110MVAR BUS REACTOR (1-PH)	765KV	50 KA FOR 1 S.	7 ✓		PMJTL	BR	TBEA
4	SF6 CIRCUIT BREAKER WITH CR, WITH CSD (3-PH)	3150A	50 KA FOR 1 S.	2 ✓		BHEL	52	MAKE TO BE INDICATED IN FINAL AS BUILT DRAWING
5	SF6 CIRCUIT BREAKER WITH CR, WITHOUT CSD (3-PH)	3150A	50 KA FOR 1 S.	2 ✓		BHEL	52	
6	SF6 CIRCUIT BREAKER WITHOUT CR, WITH CSD (3-PH)	3150A	50 KA FOR 1 S.	7 ✓		BHEL	52	
7	SF6 CIRCUIT BREAKER WITHOUT CR, WITH CSD (1-PH) PROVISION	3150A	50 KA FOR 1 S.	1 ✓		BHEL	52	
8	ISOLATOR WITH ONE E/SW (3 PH) VERTICAL KNEE TYPE	3150A	50 KA FOR 1 S.	12 ✓		BHEL	89/89E	
9	ISOLATOR WITH TWO E/SW (3 PH) VERTICAL KNEE TYPE	3150A	50 KA FOR 1 S.	8 ✓		BHEL	89/89E1 /89E2	
10	ISOLATOR WITH ONE E/SW (1 PH) VERTICAL KNEE TYPE	2000A	50 KA FOR 1 S.	21 ✓		BHEL	89/89E1	
11	ISOLATOR WITHOUT E/SW (1 PH.) VERTICAL KNEE TYPE	2000A	50 KA FOR 1 S.	33 ✓		BHEL	89	
12	CURRENT TRANSFORMER (1 PH.) WITH 120% EXTENDED CURRENT RATING.	3000A	50 KA FOR 1 S.	27 ✓		BHEL	CT	
13	CVT (1 PH.)	8800pF		12 ✓		BHEL	CVT	
14	SURGE ARRESTER (1 PH.)	624 kV		27 ✓		BHEL	LA	
15	WAVE TRAP (1 PH.) PEDESTAL TYPE.	1mH, 3150A	50 KA FOR 1 S.	04 ✓		BHEL	WT	

SL.NO.	DESCRIPTION	RATING	QTY (NO.)	SYMBOL	SCOPE OF SUPPLY	LEGEND
61	SURGE ARRESTER (1 PH.)	132 kV, 10 KA 5 KJ/KV	2 ✓		PMJTL	NLA
62	NEUTRAL CT. (1 PH.) WITH 120% EXTENDED CURRENT RATING.	33KV	4 ✓		BHEL	NCT

NOTE:

FOR AUX BUS ARRANGEMENT DETAILS FOR ICT, REFER DRG. NO. TB-3-395-510-012A
FOR AUX BUS ARRANGEMENT DETAILS FOR LINE REACTOR & BUS REACTOR, REFER DRG. NO. TB-3-395-510-011A

NOA NO. : MJTL/765kV/ERSS-XVIII/SS01/NOA-I/03(I) & NOA-II/03(II) dated 29.09.2017


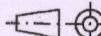
ADDITIONAL INFORMATION W.O.No. 87003		श्रावक/परियोजना का नाम NAME OF CUSTOMER/PROJECT NAME OF CONSULTANT POWERGRID MEDINIPUR JEERAT TRANSMISSION LIMITED POWERGRID CORPORATION OF INDIA LIMITED	
STATUS OF DRAWING CONTRACT DISTRIBUTION OF PRINTS		SUBSTATION PACKAGE-SS01 FOR ESTABLISHMENT OF 765/400KV S/S AT MEDINIPUR & JEERAT (NEW) ASSOCIATED WITH TRANSMISSION SYSTEM PROJECT "765KV STRENGTHENING IN EASTERN REGION(ERS-SXVII)" UNDER TARIFF BASED COMPETITIVE BIDDING (TBCB) ROUTE.	
		भारता हेवी इलेक्ट्रिकल्स लिमिटेड दासगिरी परियोजना विभाग BHARAT HEAVY ELECTRICALS LTD. TRANSMISSION PROJECTS DIVISION	
REV. 01 DATE 15.11.17 ZONE		ALTERED PK CHECKED MM/RD APPROVED DKM/VK	विभाग TBEM कोड कोड
DRG REVISED AS PER PGCL COMMENTS DATED 01.11.17		 अनुपात / SCALE NTS	कर्ड कोड CARD CODE
शीर्षक/TITLE SINGLE LINE DIAGRAM FOR 765/400KV JEERAT S/S.		ड्राईंग क्र./DRAWING NO. TB-3-395-510-001	पृष्ठ क्र./REV. 02
		पृष्ठ क्र./SHEET No.01	उगला पृष्ठ/NEXT SHEET 02

THE INFORMATION ON THIS DOCUMENT IS THE PROPERTY OF BHARAT HEAVY ELECTRICALS LIMITED. IT MUST NOT BE USED DIRECTLY OR INDIRECTLY IN ANY WAY DETRIMENTAL TO THE INTEREST OF THE COMPANY

INVENTORY NO. _____
DATE _____
REF. DES. NO. _____
COMPUTER FILE NAME _____

FIRST ANGLE PROJECTION (ALL DIMENSIONS ARE IN MM.)

DRG. NO. TB-0-395-316-013

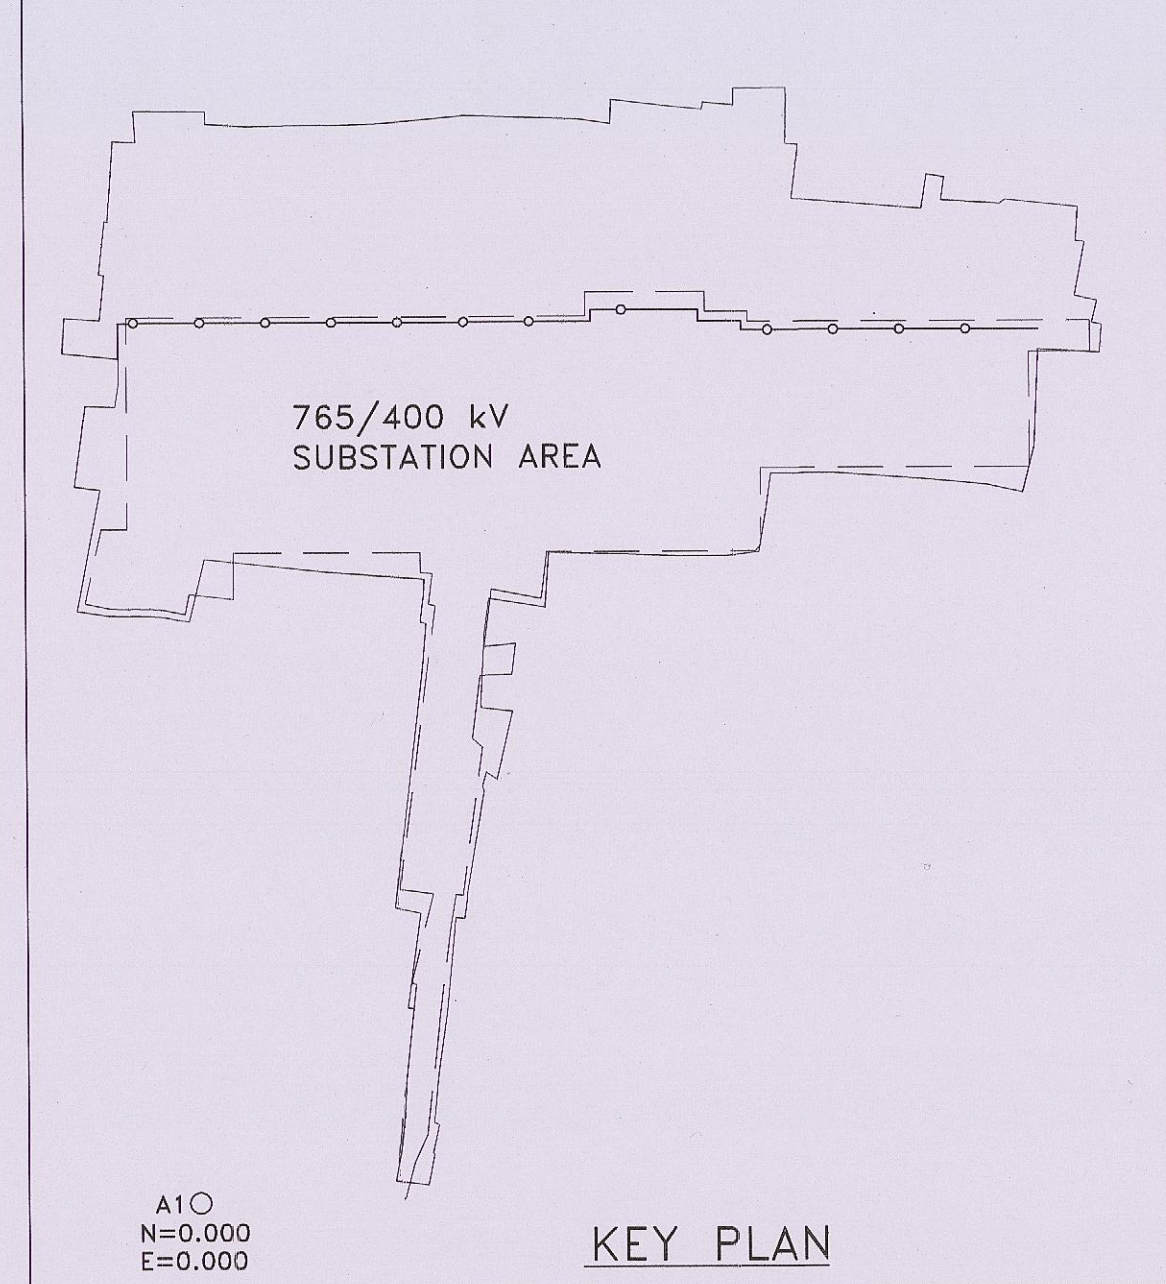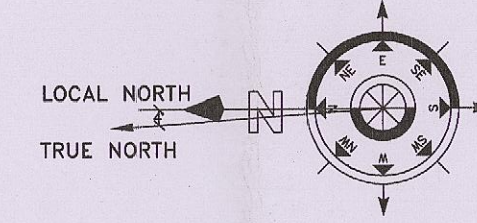


NOTE:-

- ALL DIMENSIONS ARE IN MM.
- THE SUBSTATION BOUNDARY WALL SHALL BE AS MARKED IN DRG. PROPOSED SUBSTATION AREA TO BE LEVELLED IS AS PER <B1 B2 B3..... B46>. (LOCAL CO-ORDINATES TO BE USED FOR SITE LEVELING. LEVELING IS IN THE SCOPE OF S/S PKG.)
- EARTH MAT TO BE LAID IN THE LEVELED AREA ONLY.
- DESTINATION OF FEEDERS MARKED AS FUTURE ARE INDICATIVE ONLY.
- LOCATIONS OF ROADS, RAIL TRACKS INSIDE THE SUBSTATION ARE TENTATIVE AND SHALL BE FINALIZED DURING DETAILED ENGINEERING.
- PREFERRED LOCATION OF TRANSMISSION LINE DEAD END TOWERS IS MARKED UP. LINE SIDE EQUIPMENT ARE LOCATED ACCORDINGLY. ANY CHANGE IN LOCATION OF DEAD END TOWERS MAY BE COMMUNICATED TO CC (ENGG.) CLEARANCE MAY BE OBTAINED BEFORE COMMENCEMENT OF WORK.
- TRANSMISSION LINE TOWERS INSIDE S/S SHALL BE LOCATED AFTER CLEARANCE FROM POWER GRID-ENGG.(CC).
- LOCATION OF LT STATION IS TENTATIVE. SAME SHALL BE FINALISED AFTER FINALISATION OF SEB SUPPLY POINT BY SITE.
- LEVELLING SHALL BE DONE AS PER DRG. NO. TB-1-395-J-607-606, SUBMITTED SEPARATELY.



LEGEND:-

---	PRESENT SCOPE
---	FUTURE SCOPE
⊞	400KV TOWER
⊞	765KV TOWER
---	RCC BOUNDARY WALL
---	CONCRETE ROAD
---	FENCE
*	WITH DOUBLE TIER ARRANGEMENT
---	LEVELING LINE

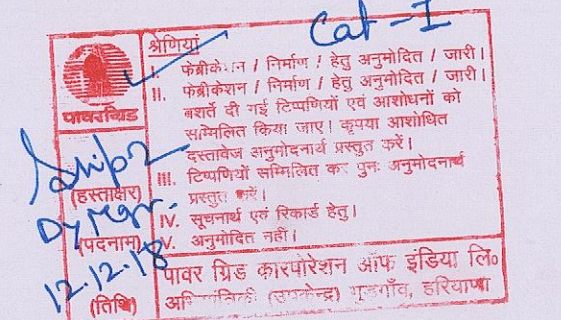

TB-1-395-J-607-606		LAYOUT SHOWING SCOPE AND LEVEL OF 765/400KV SUB-STATION JEERAT	
REF. DRG.		TITLE	
NOA NO. : MJTL/765KV/ERSS-XVII/SSOI/NOA-1/03(1) & NOA-II/03(1)		dated 29.09.2017	
NAME OF CUSTOMER/PROJECT		POWERGRID MEDINIPUR JEERAT TRANSMISSION LIMITED	
NAME OF CONSULTANT		POWER GRID CORPORATION OF INDIA LIMITED	
ADDITIONAL INFORMATION		SUBSTATION PACKAGE-SSOI FOR ESTABLISHMENT OF 765/400KV S/S AT MEDINIPUR & JEERAT (NEW) ASSOCIATED WITH TRANSMISSION SYSTEM PROJECT "765KV STRENGTHENING IN EASTERN REGION (ERSS-XVII)" UNDER TARIFF BASED COMPETITIVE BIDDING (TBCB) ROUTE.	
W.D.NO. 87503		CONTRACT	
STATUS OF DRAWING		DISTRIBUTION OF PRINTS	
REV. DATE		REV. DATE	
01 13.08.19		02 28.11.19	
03 27.02.19		04 27.02.19	
05 27.02.19		06 27.02.19	
07 27.02.19		08 27.02.19	
547 27.02.19		548 27.02.19	

TORY MO

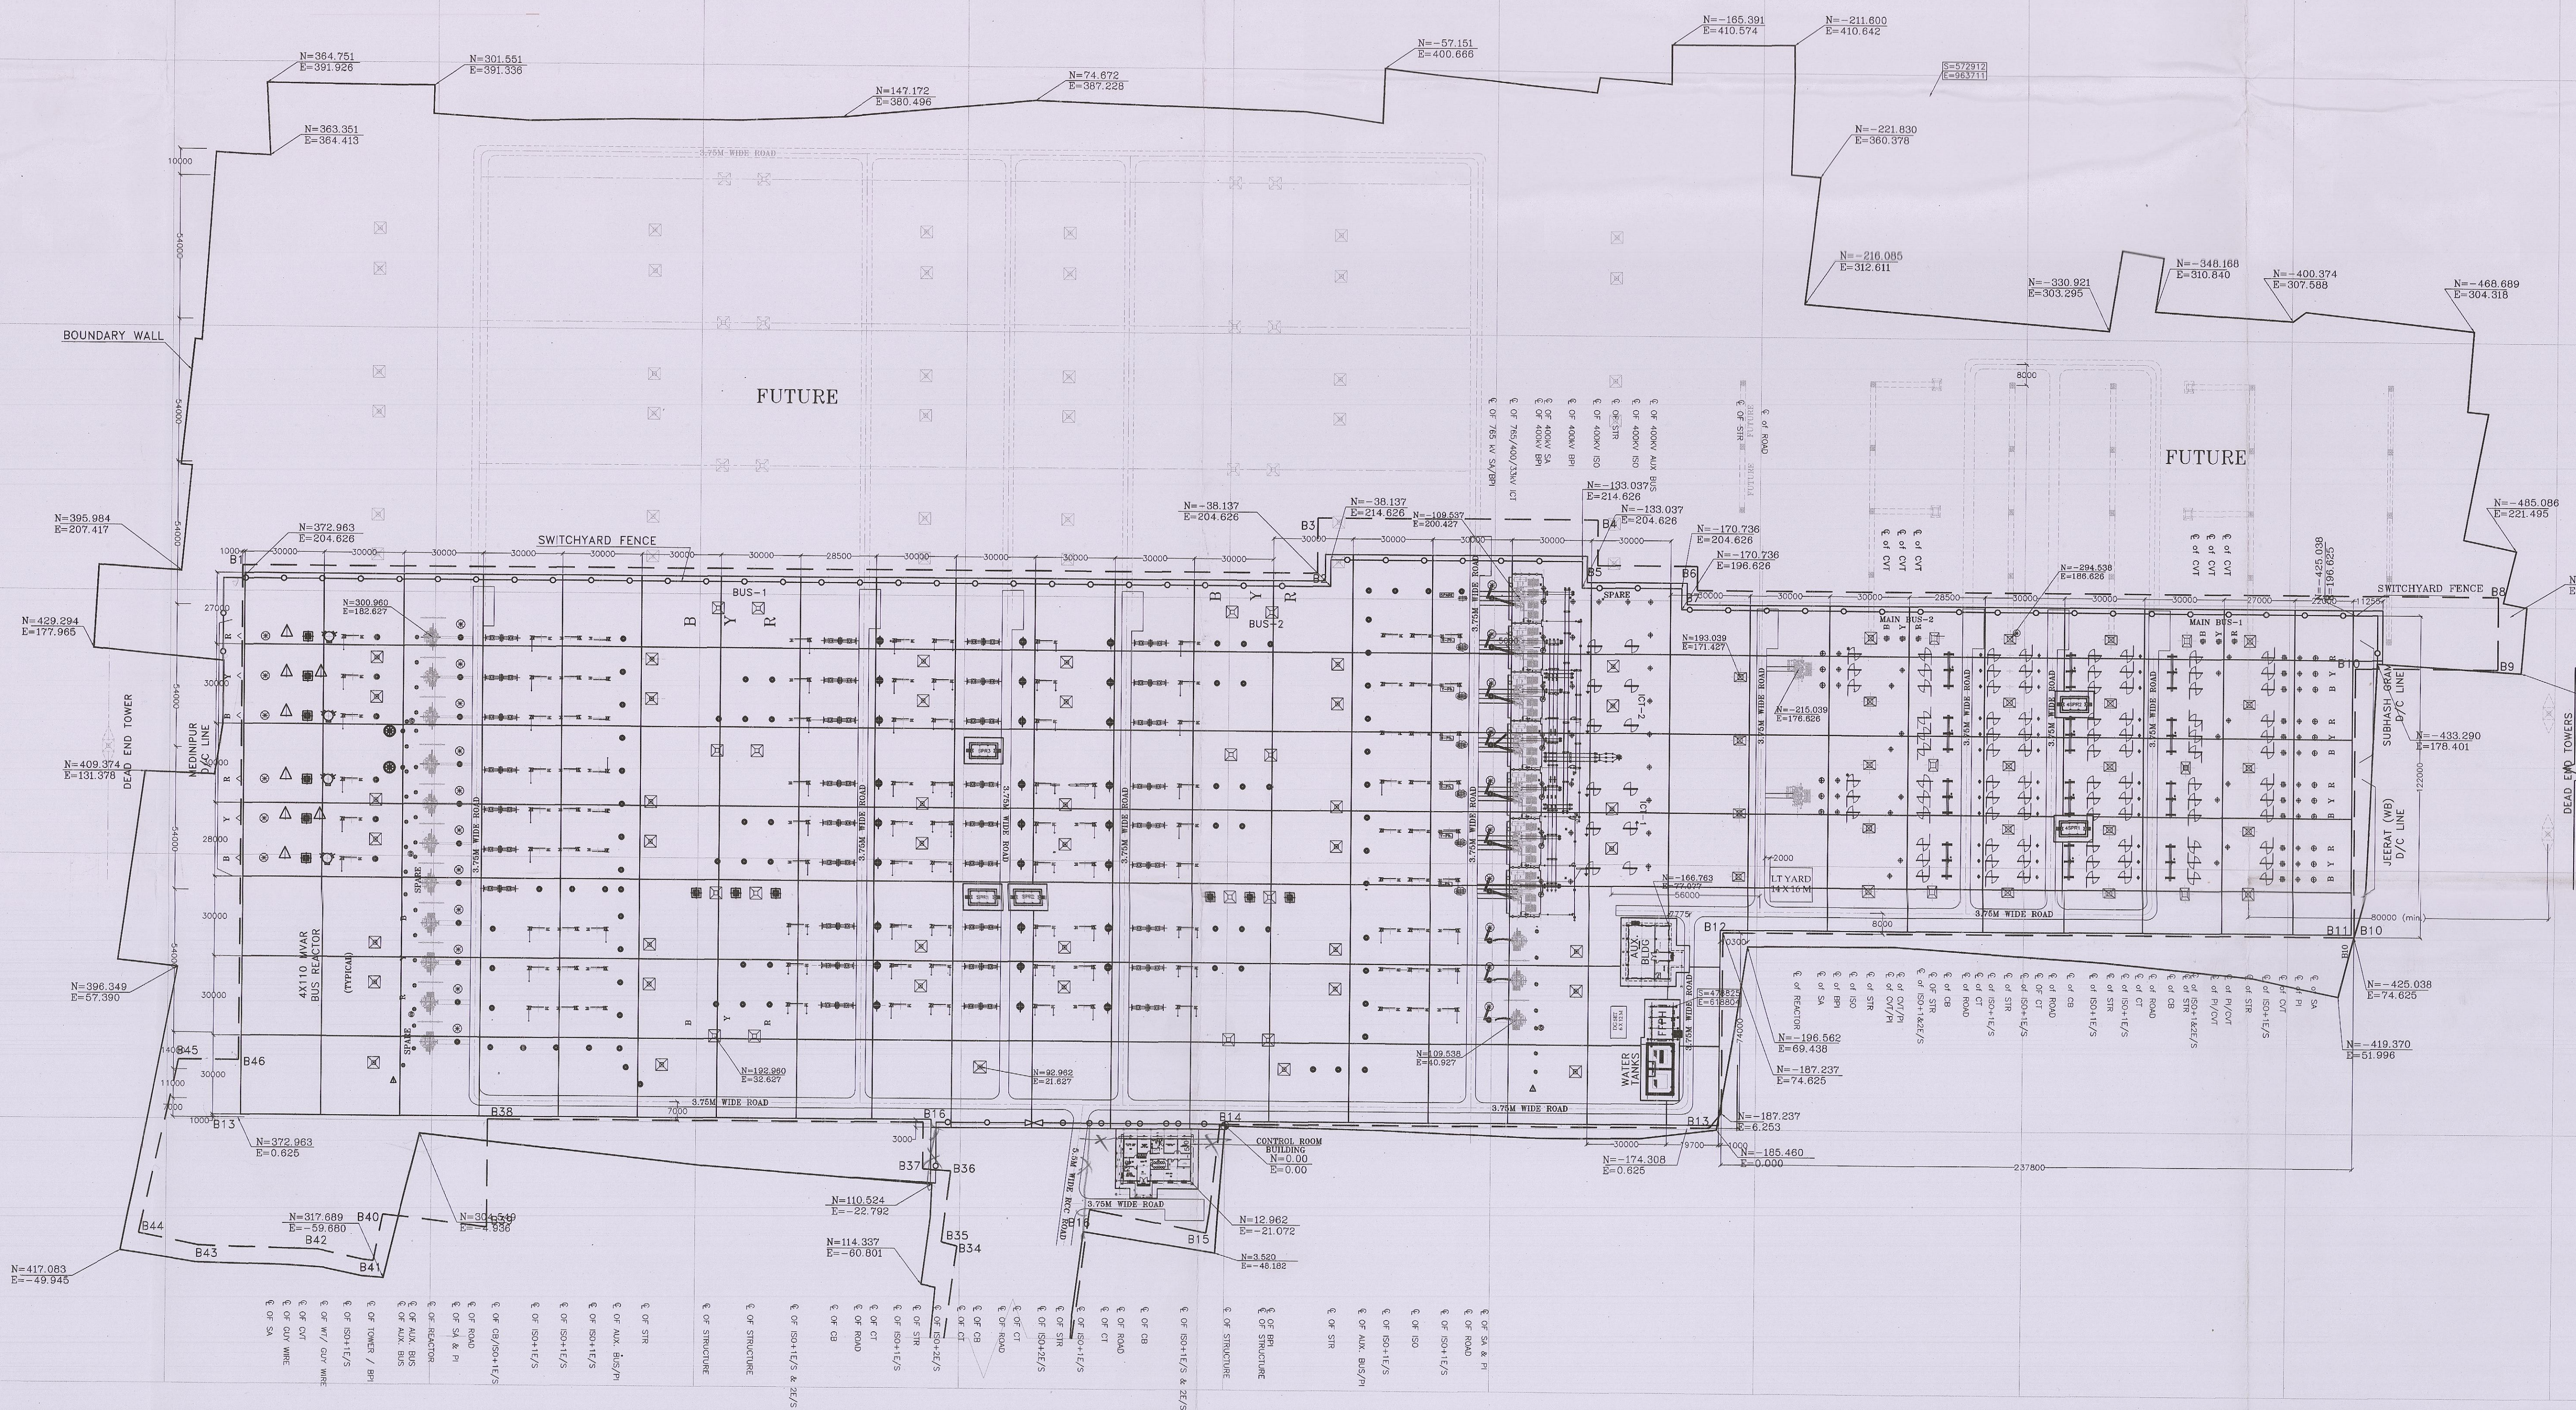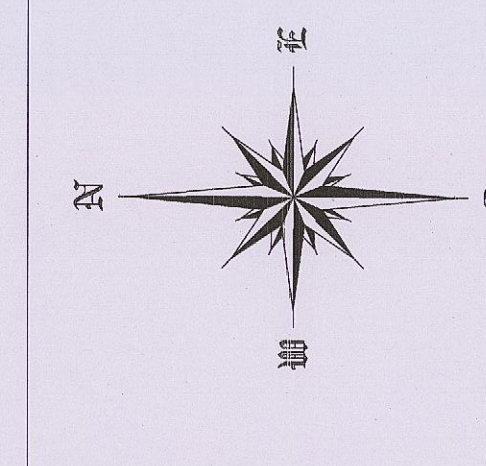
$$E = -100.00$$
$$N = -600.00$$


LEGEND

- [illegible]

SYMBOL	DESCRIPTION	ESTIMATED QTY.
	40mm# M.S. ROD. - MAIN EARTH-MAT	= 13 KM = 128.18 MT (1km = 9.26 MT)

* Payment shall be made as actual executed qty

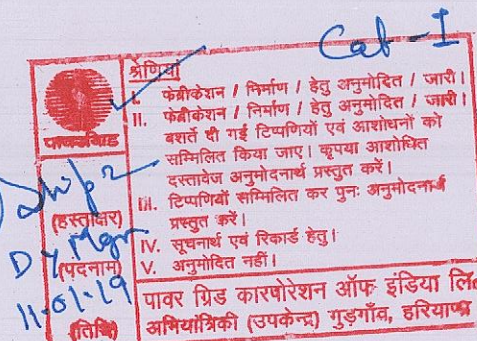[illegible]