


Appendix-A

Transmission scheme for evacuation of 4.5 GW RE injection at Khavda P.S. under Phase-II – Part D

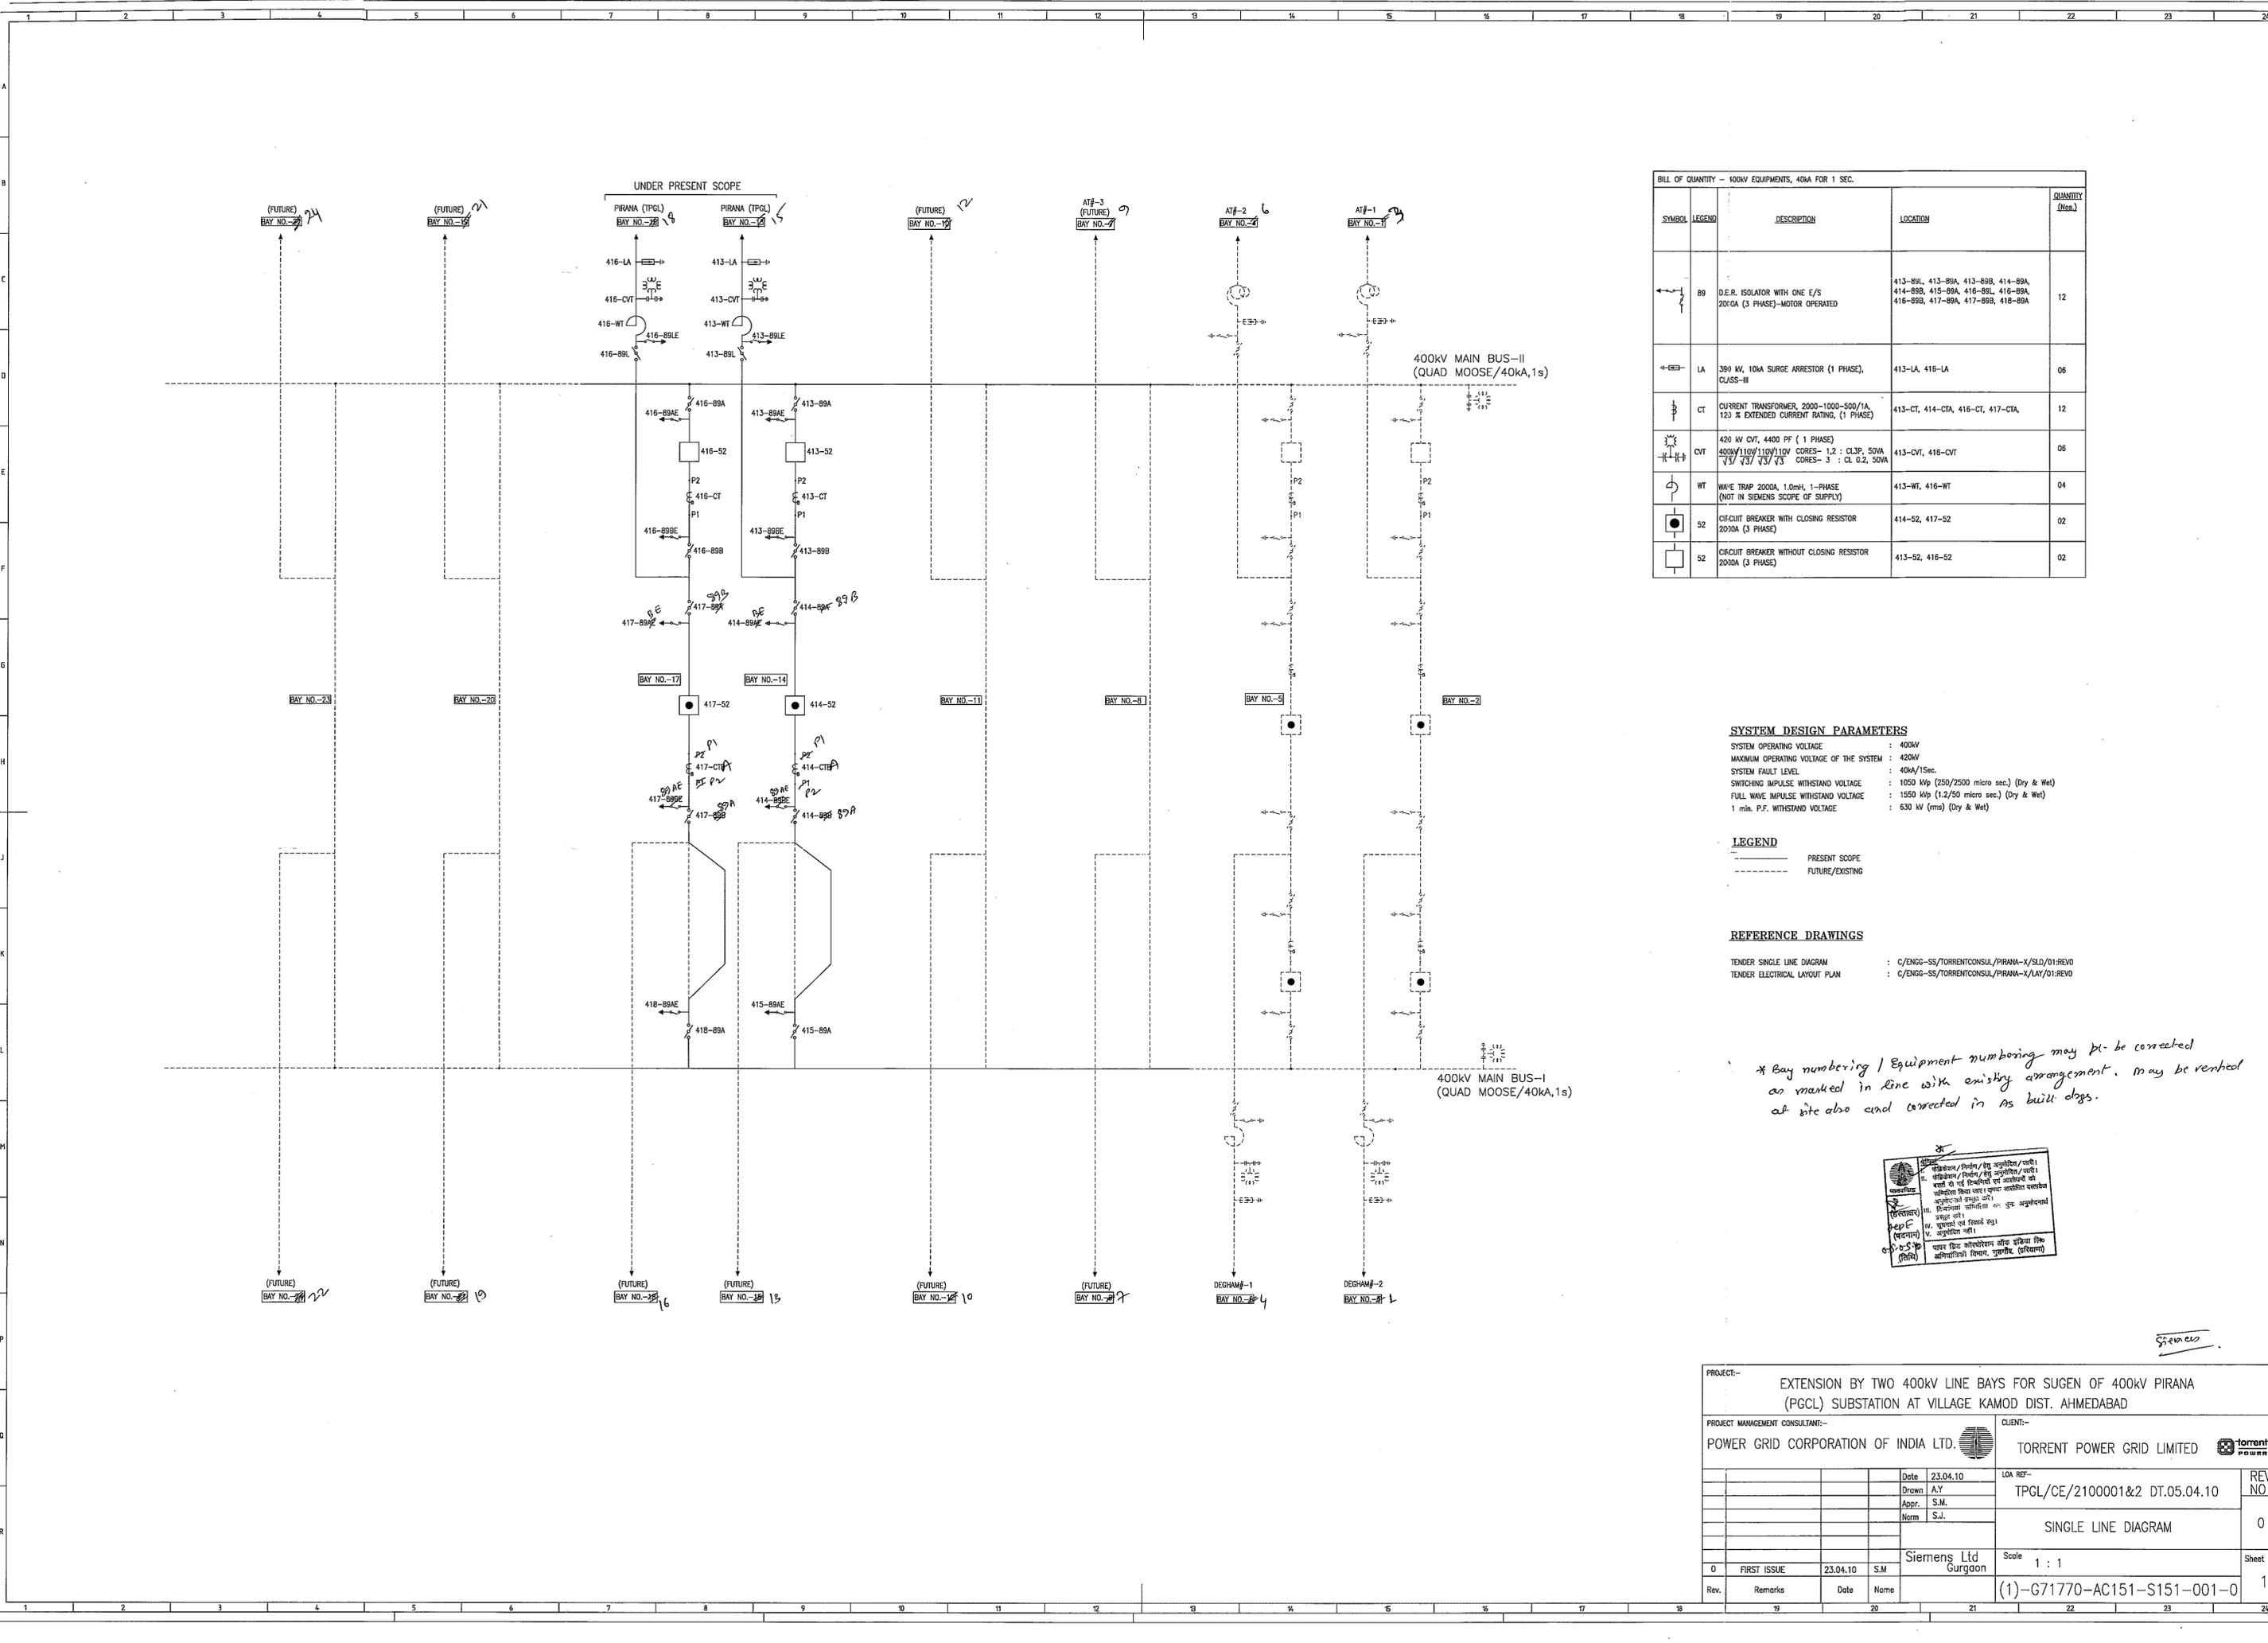

BILL OF QUANTITY - 400KV EQUIPMENTS, 40KA FOR 1 SEC.				
SYMBOL	LEGEND	DESCRIPTION	LOCATION	QUANTITY (Nos.)
↔	B9	D.E.R. ISOLATOR WITH ONE E/S 20FOA (3 PHASE)-MOTOR OPERATED	413-B9L, 413-S9A, 413-S9B, 414-S9A, 414-S9B, 415-S9A, 416-S9L, 416-S9A, 416-S9B, 417-S9A, 417-S9B, 418-S9A	12
⚡	LA	390 KV, 10KA SURGE ARRESTOR (1 PHASE), CLASS-III	413-LA, 418-LA	06
⚡	CT	CURRENT TRANSFORMER, 2000-1000-500/1A, 120 % EXTENDED CURRENT RATING, (1 PHASE)	413-CT, 414-CTA, 416-CT, 417-CTA	12
⚡	CVT	420 KV CVT, 4400 PF (1 PHASE) 400KV/110KV/110KV/110V CORES- 1,2 : CL3P, 50VA 13/ 13/ 13/ 13 CORES- 3 : CL Q.2, 50VA	413-CVT, 416-CVT	06
⚡	WT	WAVE TRAP 2000A, 1.0mH, 1-PHASE (NOT IN SIEMENS SCOPE OF SUPPLY)	413-WT, 416-WT	04
⚡	52	CIRCUIT BREAKER WITH CLOSING RESISTOR 2000A (3 PHASE)	414-S2, 417-S2	02
⚡	52	CIRCUIT BREAKER WITHOUT CLOSING RESISTOR 2000A (3 PHASE)	413-S2, 416-S2	02

SYSTEM DESIGN PARAMETERS

- SYSTEM OPERATING VOLTAGE : 400KV
- MAXIMUM OPERATING VOLTAGE OF THE SYSTEM : 420KV
- SYSTEM FAULT LEVEL : 40KA/1Sec.
- SWITCHING IMPULSE WITHSTAND VOLTAGE : 1050 kVp (250/2500 micro sec.) (Dry & Wet)
- FULL WAVE IMPULSE WITHSTAND VOLTAGE : 1550 kVp (1.2/50 micro sec.) (Dry & Wet)
- 1 min. P.F. WITHSTAND VOLTAGE : 630 kV (rms) (Dry & Wet)

LEGEND

- PRESENT SCOPE
- - - FUTURE/EXISTING



REFERENCE DRAWINGS

- TENDER SINGLE LINE DIAGRAM : C/ENGG-SS/TORRENTCONSUL/PIRAMA-4/SLD/01.REV0
- TENDER ELECTRICAL LAYOUT PLAN : C/ENGG-SS/TORRENTCONSUL/PIRAMA-4/LAY/01.REV0

* Bay numbering / Equipment numbering may be corrected as marked in line with existing arrangement. may be checked at site also and corrected in as built docs.

સાચીકોઈપણ/કોઈપણ અંગ્રહીક/ગણતરી
 1. સંકેત/સંકેત/સંકેત/સંકેત
 2. સંકેત/સંકેત/સંકેત/સંકેત
 3. સંકેત/સંકેત/સંકેત/સંકેત
PROJECT:-		EXTENSION BY TWO 400KV LINE BAYS FOR SUGEN OF 400KV PIRANA (PGCL) SUBSTATION AT VILLAGE KAMOD DIST. AHMEDABAD	
PROJECT MANAGEMENT CONSULTANT:-		CLIENT:-	
POWER GRID CORPORATION OF INDIA LTD.		TORRENT POWER GRID LIMITED	
Date	23.04.10	LOA REF-	TPGL/CE/2100001&2 DT.05.04.10
Drawn	A.Y.	REV NO	0
Appr.	S.M.	SINGLE LINE DIAGRAM	
Norm	S.J.	Scale	1 : 1
Siemens Ltd Gurgaon		Sheet	1
Rev.	Remarks	Date	Name
0	FIRST ISSUE	23.04.10	S.M
		(1)-G71770-AC151-S151-001-0	

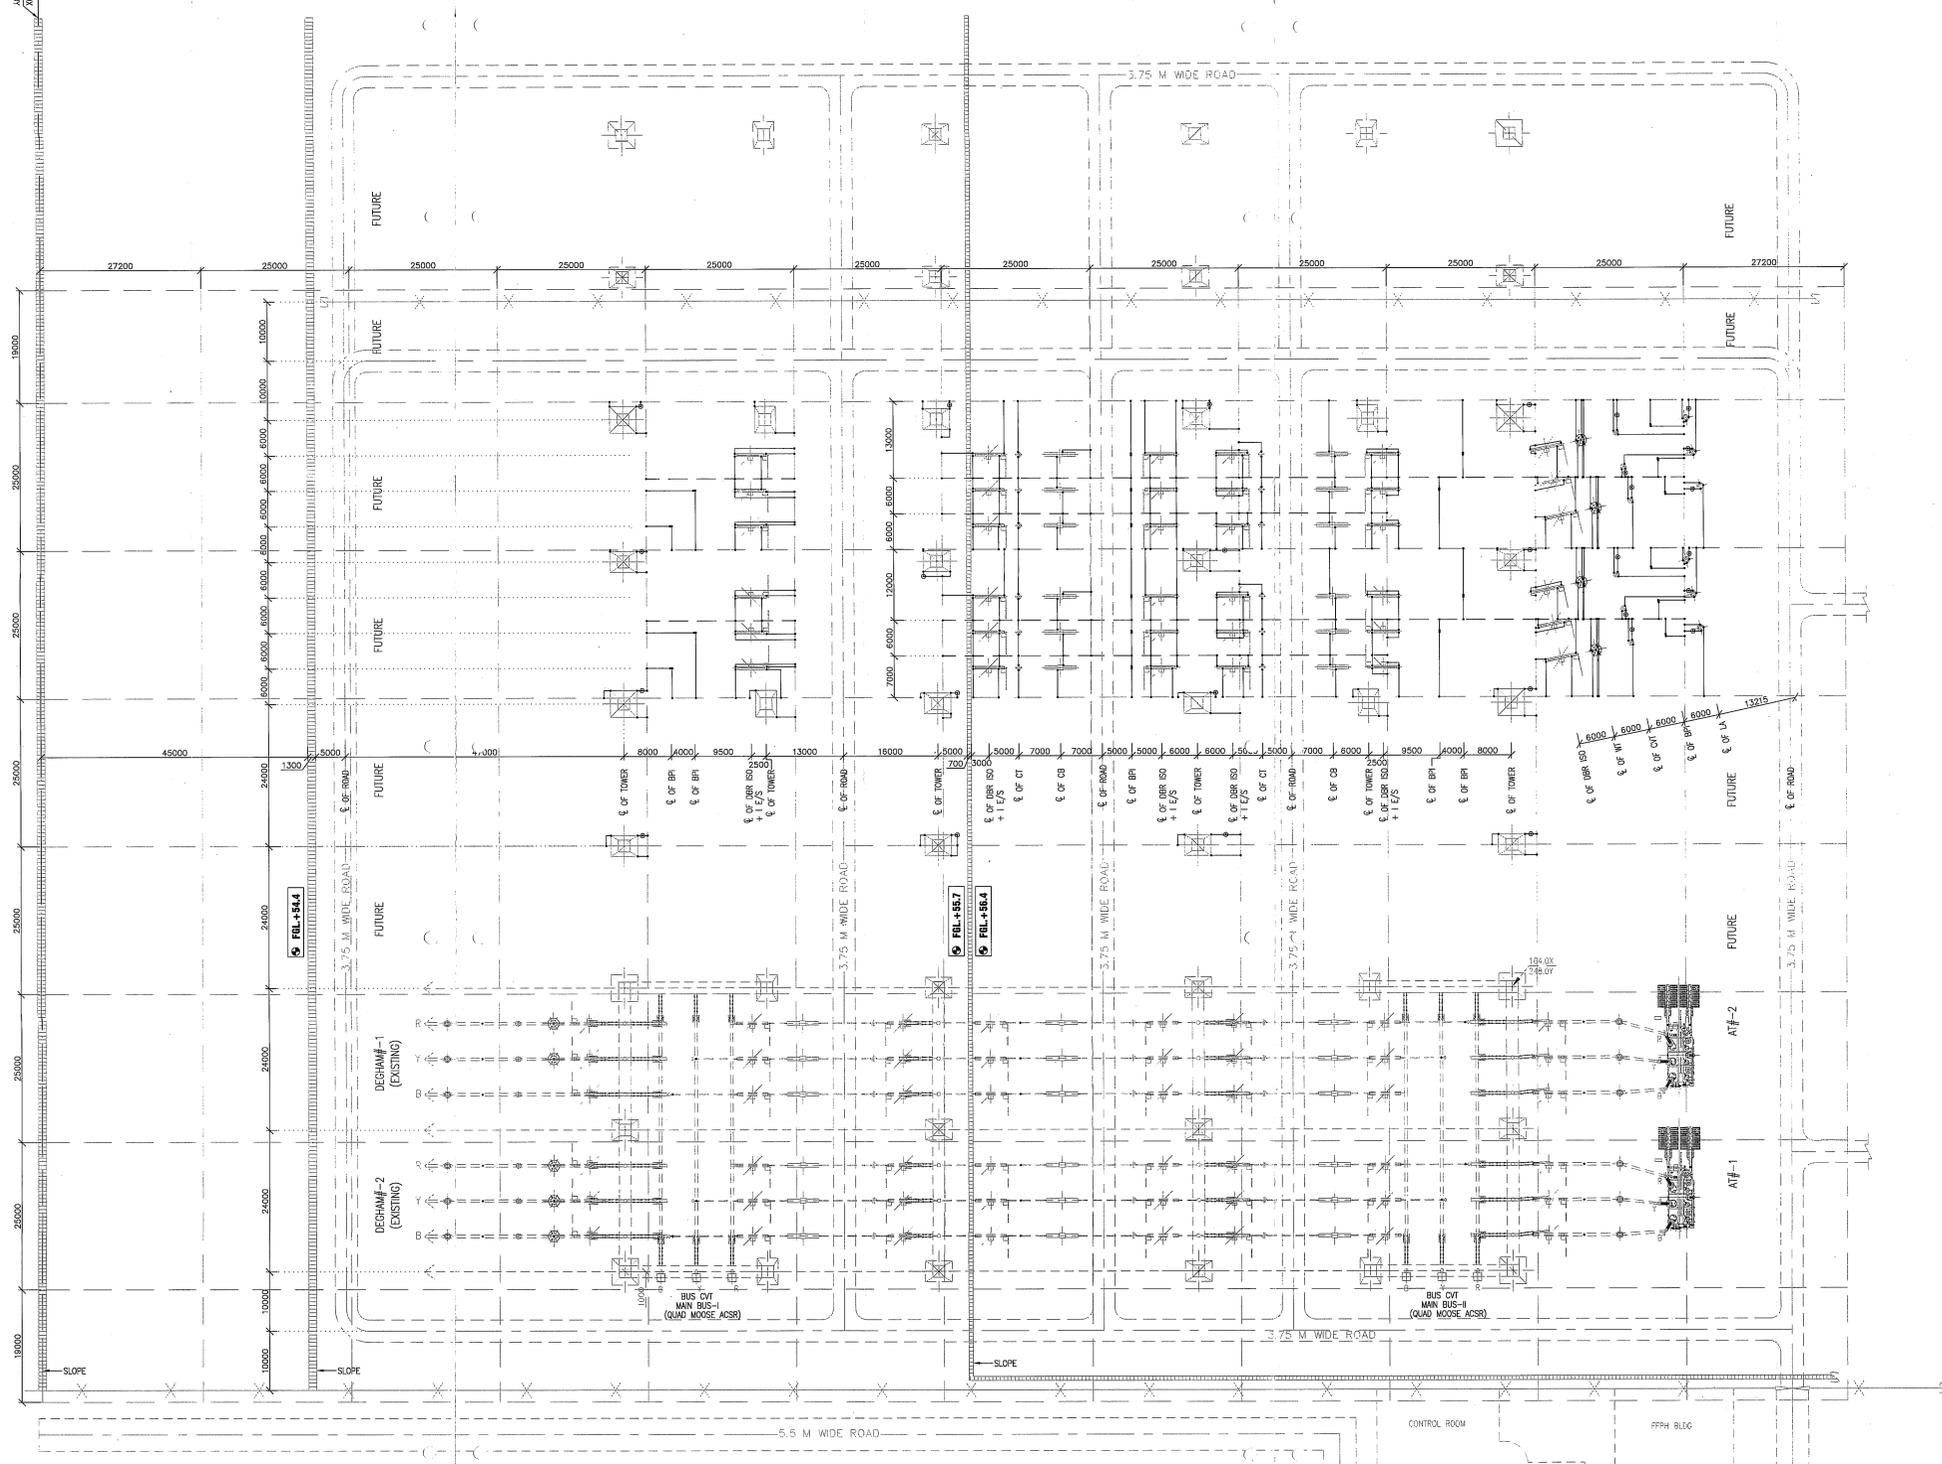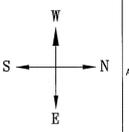

- NOTES:-**
- ALL DIMENSIONS ARE IN MILLIMETERS UNLESS OTHERWISE SPECIFIED.
 - MAIN EARTHING CONDUCTOR WILL BE LAID 600MM BELOW FROM THE GROUND LEVEL.
 - EARTHING CONDUCTOR RUNNING C/W LOW CABS, TRENCHES, DRAINS & RAIL WILL BE LAID 300MM BELOW THEM.
 - THIS DRAWING IS ONLY SYMBOLIC REPRESENTATION OF EARTHING CONDUCTOR LAYOUT. AT ACTUAL SITE CONDITION CONDUCTOR WILL BE ROUTED IN SUCH MANNER SO THAT IT DOESNOT FOUL WITH ANY FOUNDATION.
 - EARTHING WILL BE LAID 2000MM BEYOND THE FENCE.
 - CABLE TRENCH EARTHING WILL BE DONE WITH 50X6 GS FLAT AND RUN ALONG THE CABLE SUPPORTING STRUCTURE. EARTH FLAT OF CABLE TRENCH WILL BE CONNECTED TO THE MAIN EARTHING AT 10MTS. INTERVAL.
 - EQUIPMENT EARTHING CONNECTION ARE DIAGRAMATIC ONLY AND WILL BE DONE AS PER SITE CONDITION.
 - FENCE WILL BE EARTHED AT ALTERNATE POST. RAIL TRACK WILL BE EARTHED AT EVERY 10MTS. INTERVAL AND AT BOTH ENDS.
 - ALL EARTHING WILL BE DONE IN ACCORDANCE WITH IS:3043 UNLESS OTHERWISE SPECIFIED IN THE TECHNICAL SPECIFICATION.
 - AUXILIARY EARTHING 1500X1500 WITH GRID SPACING 300MM WILL BE PLACED BELOW ISOLATOR MOM & EDM AT 300MM DEPTH FROM GROUNDING LEVEL. THIS WILL BE DONE AS PER THE ACTUAL LOCATION OF MOM & EDM BOX AT SITE FOR DETAILS OF CONNECTION OF AUX EARTHINGS TO MAIN EARTHING REFER GROUNDING NOTES & DETAILS (DETAIL NO.-241)
 - ROD EARTH ELECTRODE DETAILS:
 - FOR LA : 06 NOS.
 - FOR CVT : 06 NOS.
 - FOR TOWER WITH PEAK : 16 NOS.
 - EACH INDIVIDUAL STRUCTURE/EQUIPMENT SHOULD BE EARTHED AND CONNECTED TO TWO DIFFERENT GRID.
 - AC KIOSK LOCATION SHOWN IS INDICATIVE ONLY. FOR ACTUAL LOCATION, CABLE TRENCH LAYOUT SHALL BE REFERRED.

- LEGEND:-**
- MAIN EARTHING GRID-40mm. MS ROD
 - RISER INTER CONNECTIONS-40 DIAMS ROD BELOW GROUND LEVEL
 - ROD EARTH ELECTRODE.
 - FENCE
 - FUTURE/HOT IN SIEMENS SCOPE OF SUPPLY
 - UNDER PRESENT SCOPE
 - LIGHTNING ARRESTER
 - CAPACITIVE VOLTAGE TRANSFORMER (CVT)
 - WAVE TRAP
 - CURRENT TRANSFORMER
 - DBR ISOLATOR WITH 1E/S
 - CIRCUIT BREAKER
 - BPH


- REFERENCE DRAWINGS:-**
- (0)-G71770-AC151-L152-001 : LAYOUT PLAN
 - C/ENG/STD/EARTHINGS : STANDARD EARTHING DETAILS GIVEN WITH SECTION : SWITCHYARD ERECTION, Rev.07 OF TECH. SPECIFICATION. (24 Sheets)

Scale: 1:400
 Date: 08.07.10
 Drawn: A.Y.
 Appr.: S.M.
 Norm: S.Y.

PROJECT:-		EXTENSION BY TWO 400KV LINE BAYS FOR SUGEN OF 400KV PIRANA (PGCL) SUBSTATION AT VILLAGE KAMOD DIST. AHMEDABAD	
PROJECT MANAGEMENT CONSULTANT:-		CLIENT:-	
POWER GRID CORPORATION OF INDIA LTD.		TORRENT POWER GRID LIMITED	
Date	08.07.10	LOA REF:-	
Drawn	A.Y.	TPGL/CE/2100001&2 DT.05.04.10	REV NO
Appr.	S.M.		0
Norm	S.Y.	EARTHING LAYOUT PLAN	Sheet
		Scale 1 : 400	1
0	FIRST ISSUE	08.07.10	A.Y.
Rev.	Remarks	Date	Name
			(0)-G71770-AC151-L163-001-0




2 NOS OF ELE SYSTEM FLOAT CUM BOOST CHARGE
 2 SET EXIDE LOW MINT BATTERY
 YKP-35 CAP AT-10HR, RATE-325 AH
 48V DC SUPPLY
 2 NOS OF ELE SYSTEM FLOAT CUM BOOST CHARGE
 2 SET EXIDE LOW MINT BATTERY
 YKP-21 CAP AT-10HR, RATE-250 AH

SINGLE LINE DIAGRAM OF 400KV NEW PIRANA S/S

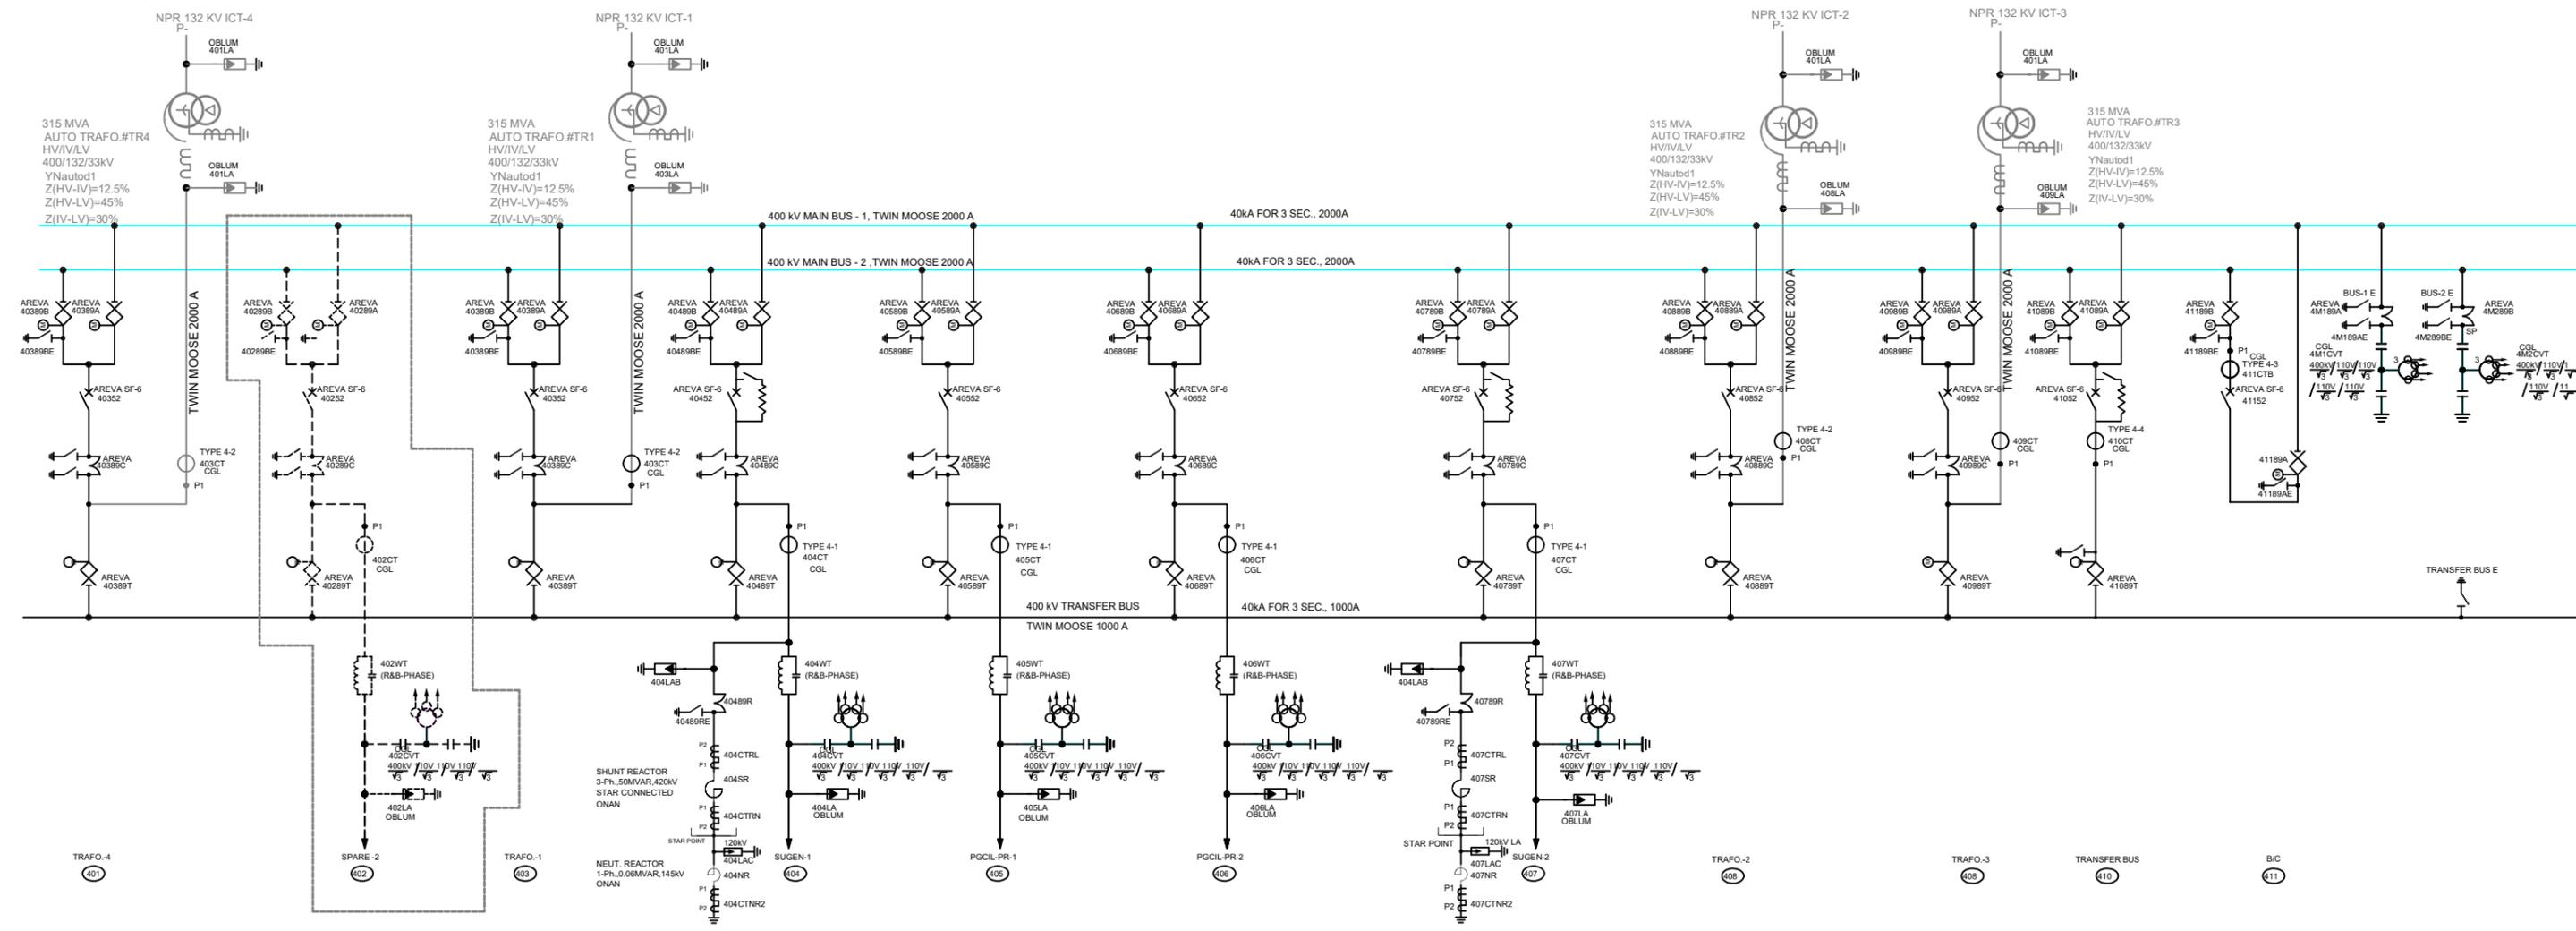

TORRENT POWER LIMITED MAINS DEPT., JUBILEE HOUSE, SHAHPUR, AHMEDABAD-380001		DRG NO: R- 400KV NPR AU1			
SINGLE LINE DIAGRAM OF 400KV NEW PIRANA S/S					
GJP	EHV-S/S	MPP	MRP	N.T.S	02.02.2019
DRN BY	SECTION	CHECKED BY	APPROVED BY	SCALE	DATE


102 ICT-4 11KV TRAF0-1 PRAHLADNAGAR-1 FUTURE
 103 104 105 PRAHLADNAGAR-2
 106 ICT-1 METRO
 107 PIRANA-3 VASNA-1
 108 109 VASNA-2
 110 B/C
 111 PIRANA-1 PIRANA-2
 112 113 U-2
 114 U-1
 115 75 MVA TR-2 132/33 KV
 116 ICT-2
 117 75 MVA TR-1 132 / 33KV
 118 LINE-3 FUTURE
 119
 120 ICT-3

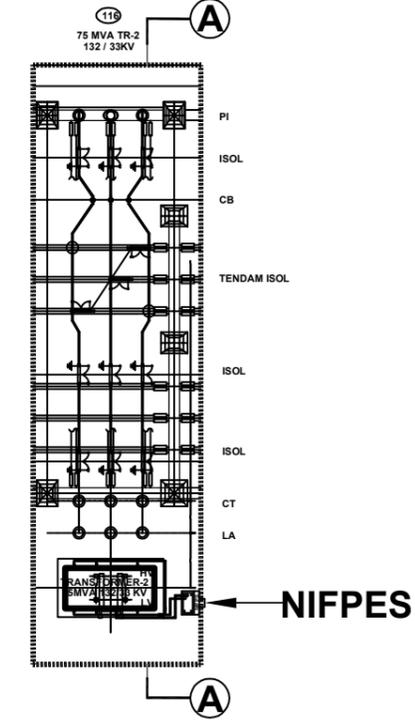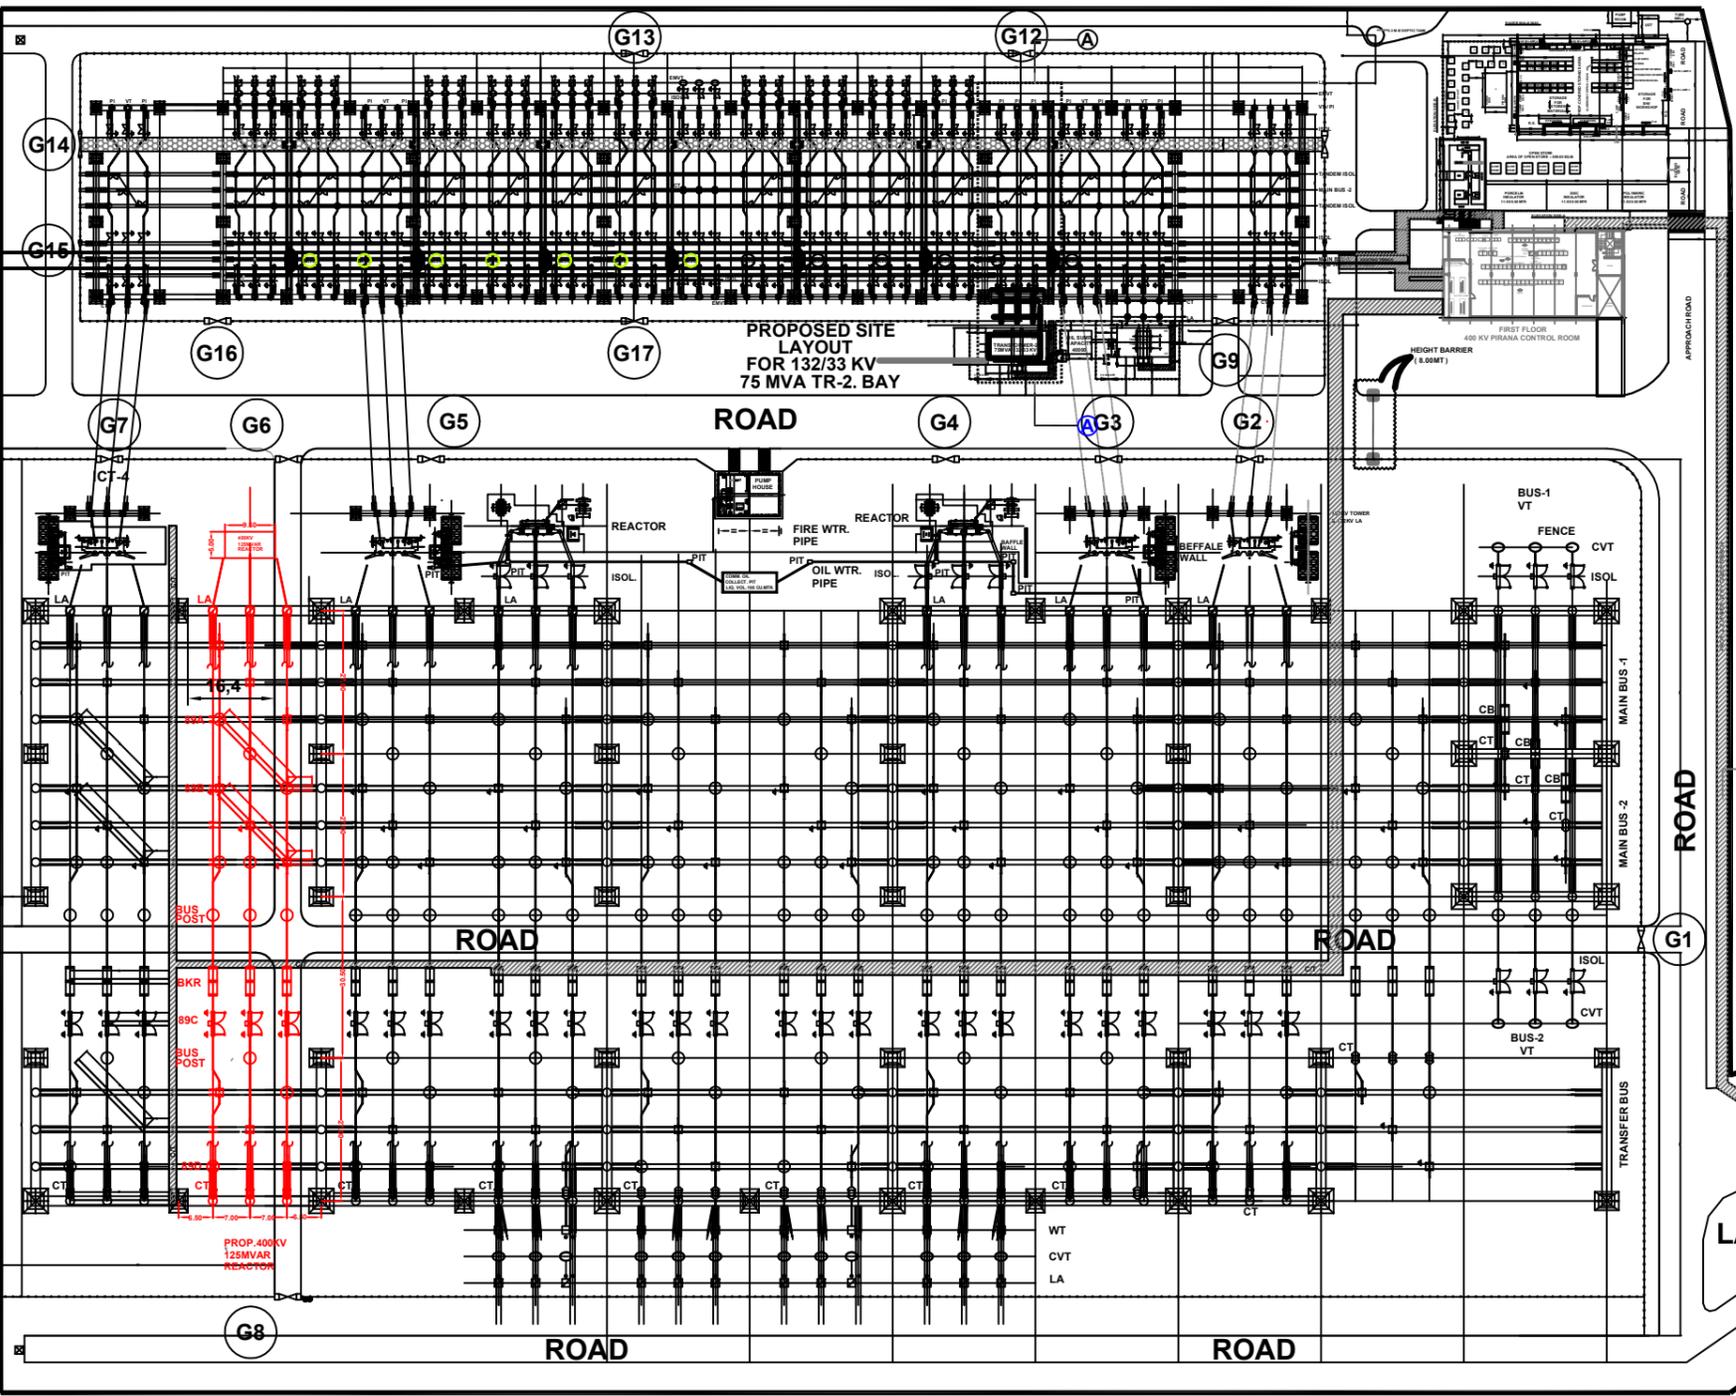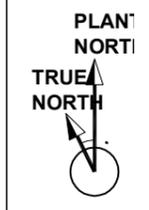

400 KV SWITCHYARD GATE DETAILS		
SR.NO	REMARK	LENGTH
G-1	MAIN GATE	AS PER SIT
G-2	MAIN GATE WITH VICKET GATE	AS PER SIT
G-3	MAIN GATE WITH VICKET GATE	AS PER SIT
G-4	MAIN GATE	AS PER SIT
G-5	MAIN GATE WITH VICKET GATE	AS PER SIT
G-6	MAIN GATE	AS PER SIT
G-7	MAIN GATE WITH VICKET GATE	AS PER SIT
G-8	MAIN GATE	AS PER SIT

132 KV SWITCHYARD GATE DETAILS		
SR.NO	REMARK	LENGTH
G-9	MAIN GATE	AS PER SIT
G-10	MAIN GATE	AS PER SIT
G-11	MAIN GATE	AS PER SIT
G-12	MAIN GATE	AS PER SIT
G-13	MAIN GATE	AS PER SIT
G-14	MAIN GATE	AS PER SIT
G-15	MAIN GATE	AS PER SIT
G-16	VICKET GATE	1 M
G-17	VICKET GATE	1 M
G-18	VICKET GATE	1 M

PROP. 2.0 M WIDE
 33 KV CABLE TRENCH
 LENGTH:-400.0 MTR

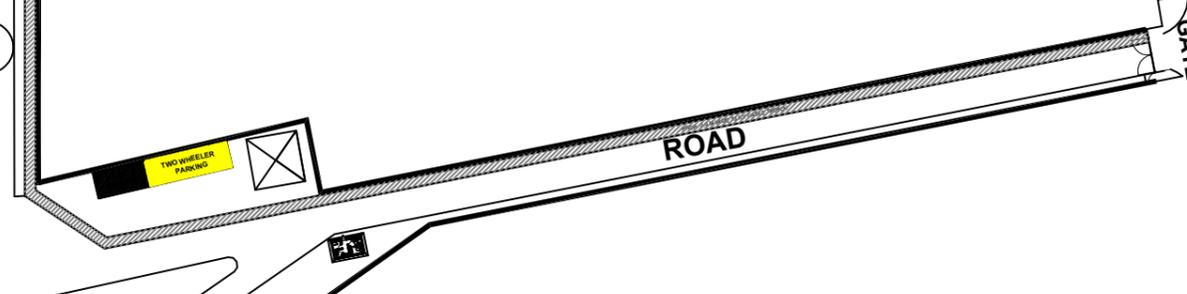

401 ICT-4
 402 SPARE BAY
 403 ICT-1
 404 SUGEN-1
 405 PGCIL-PR-1
 406 PGCIL-PR-2
 407 SUGEN-2
 408 ICT-2
 409 ICT-3
 410 B/T
 411 B/C

ALTERNATE-1

LEGEND	
EXISTING WORK	SHOWN ———
PROP.400KV 125 MVAR REACTOR	SHOWN ———

PROJECT	
PROP.400KV 125 MVAR REACTOR AT 400 / 132KV PIRANA S/S	
TITLE	
SITE LAYOUT PLAN	
OWNER	
TORRENT POWER LTD.	
DRAWN : CBP/BKP	CHECKED : SRK
REVIEWED : MBD	DATE : 21/08/2019
APPROVED : PKP	JOB NO : K8B03
DWG. NO. NPR-1	REV. 0